



South Elevation

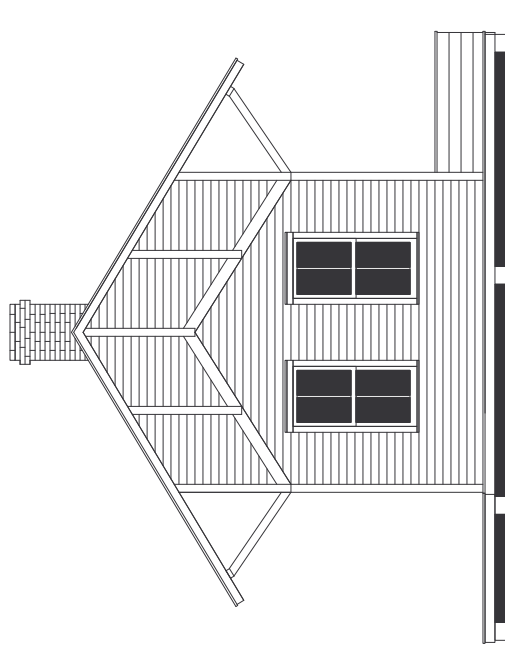

North Elevation

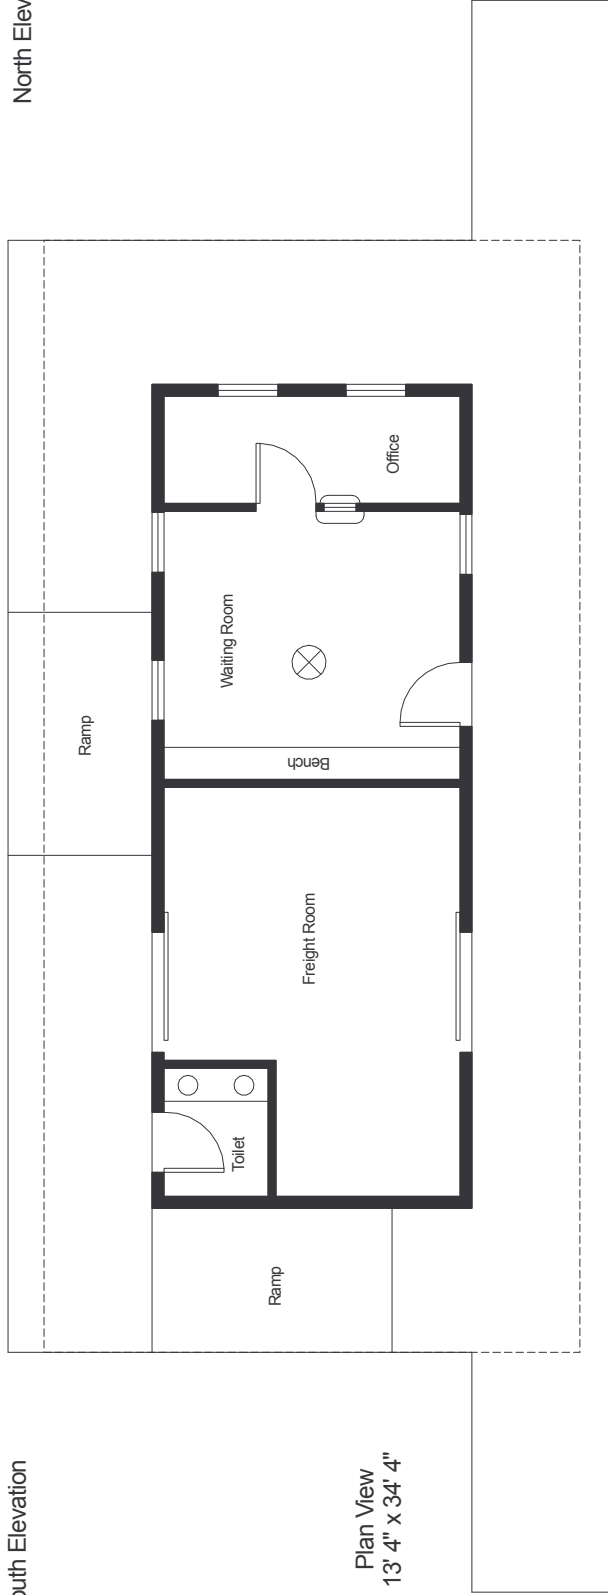

Plan View
13' 4" x 34' 4"



Scale: 1/8" = 1'

Based on D&H drawing from 9/10/31, f.m. & photos / JRP 1/2001

DELAWARE & HUDSON RAILROAD Kings Station

as built in 1887